




757 THIRD AVE

*Floor - 08*

*As-Built Plan*

*Suite B*

*13,458 SF*

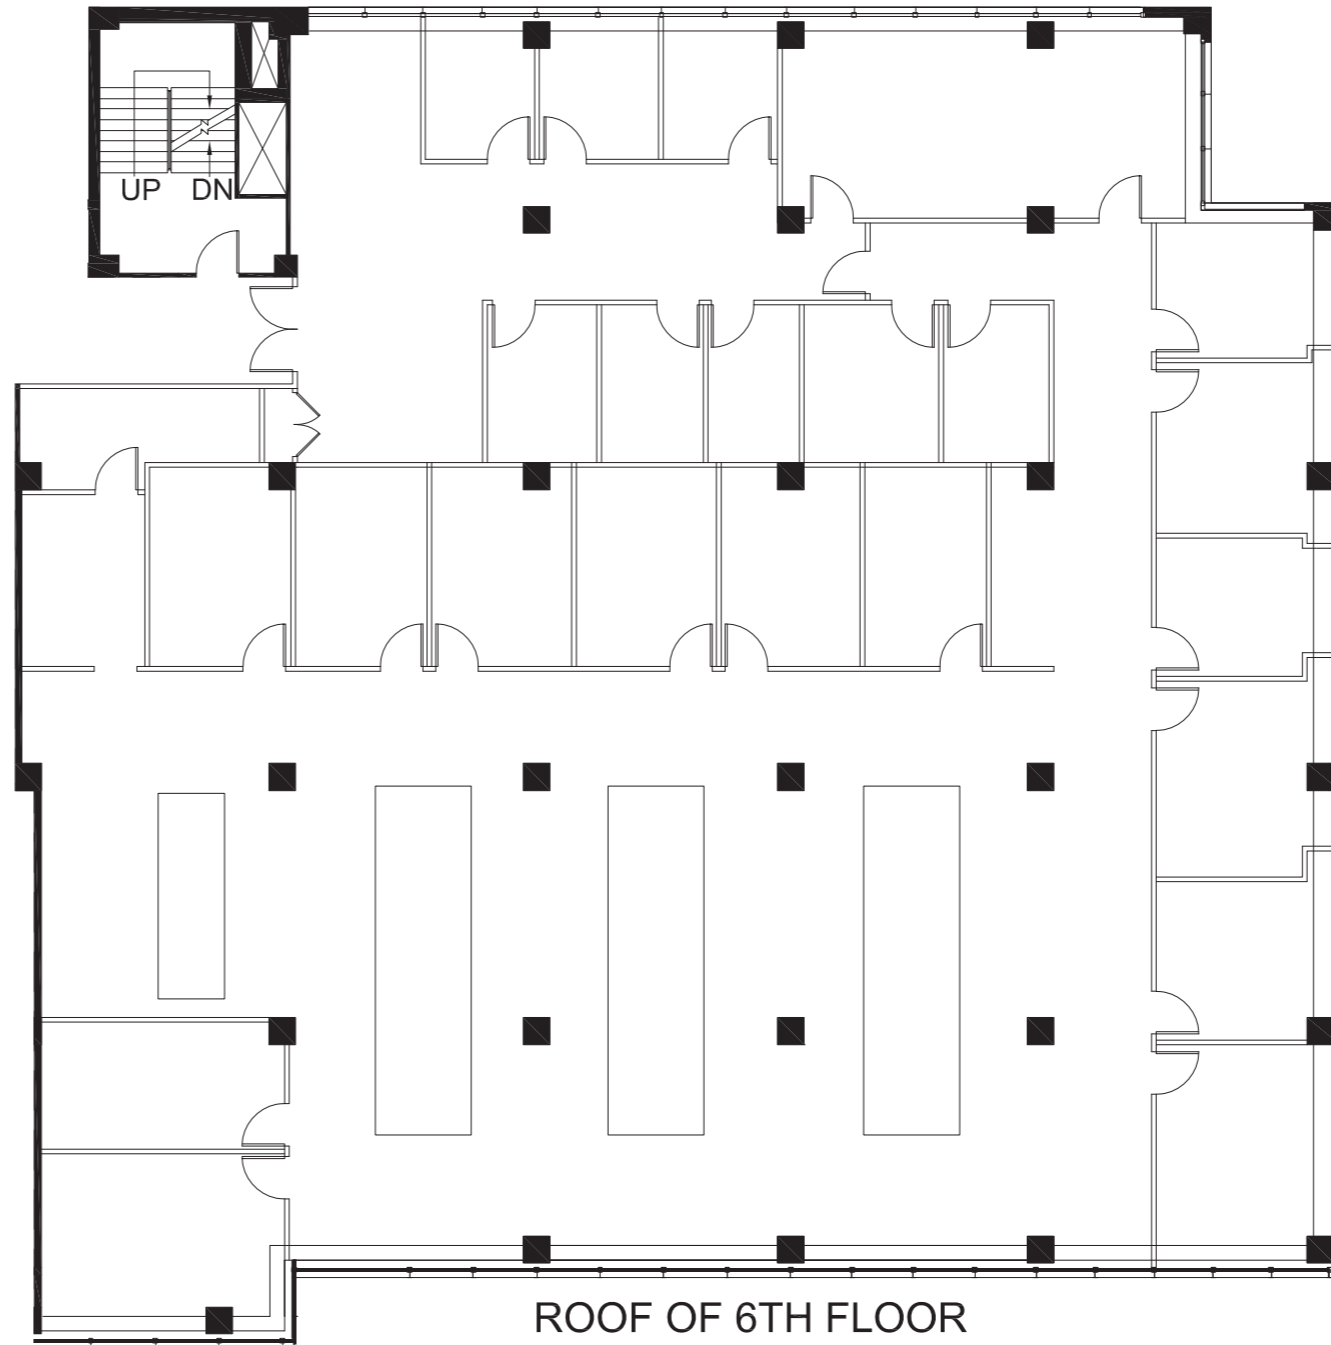

*E 47TH STREET*

