



757 THIRD AVE

Floor - 22

As-Built Plan

6,960 SF

Single Suite

Workstations 14


Offices 8

Conference Rooms 2

Phone Room 1

Reception 1

Total 26

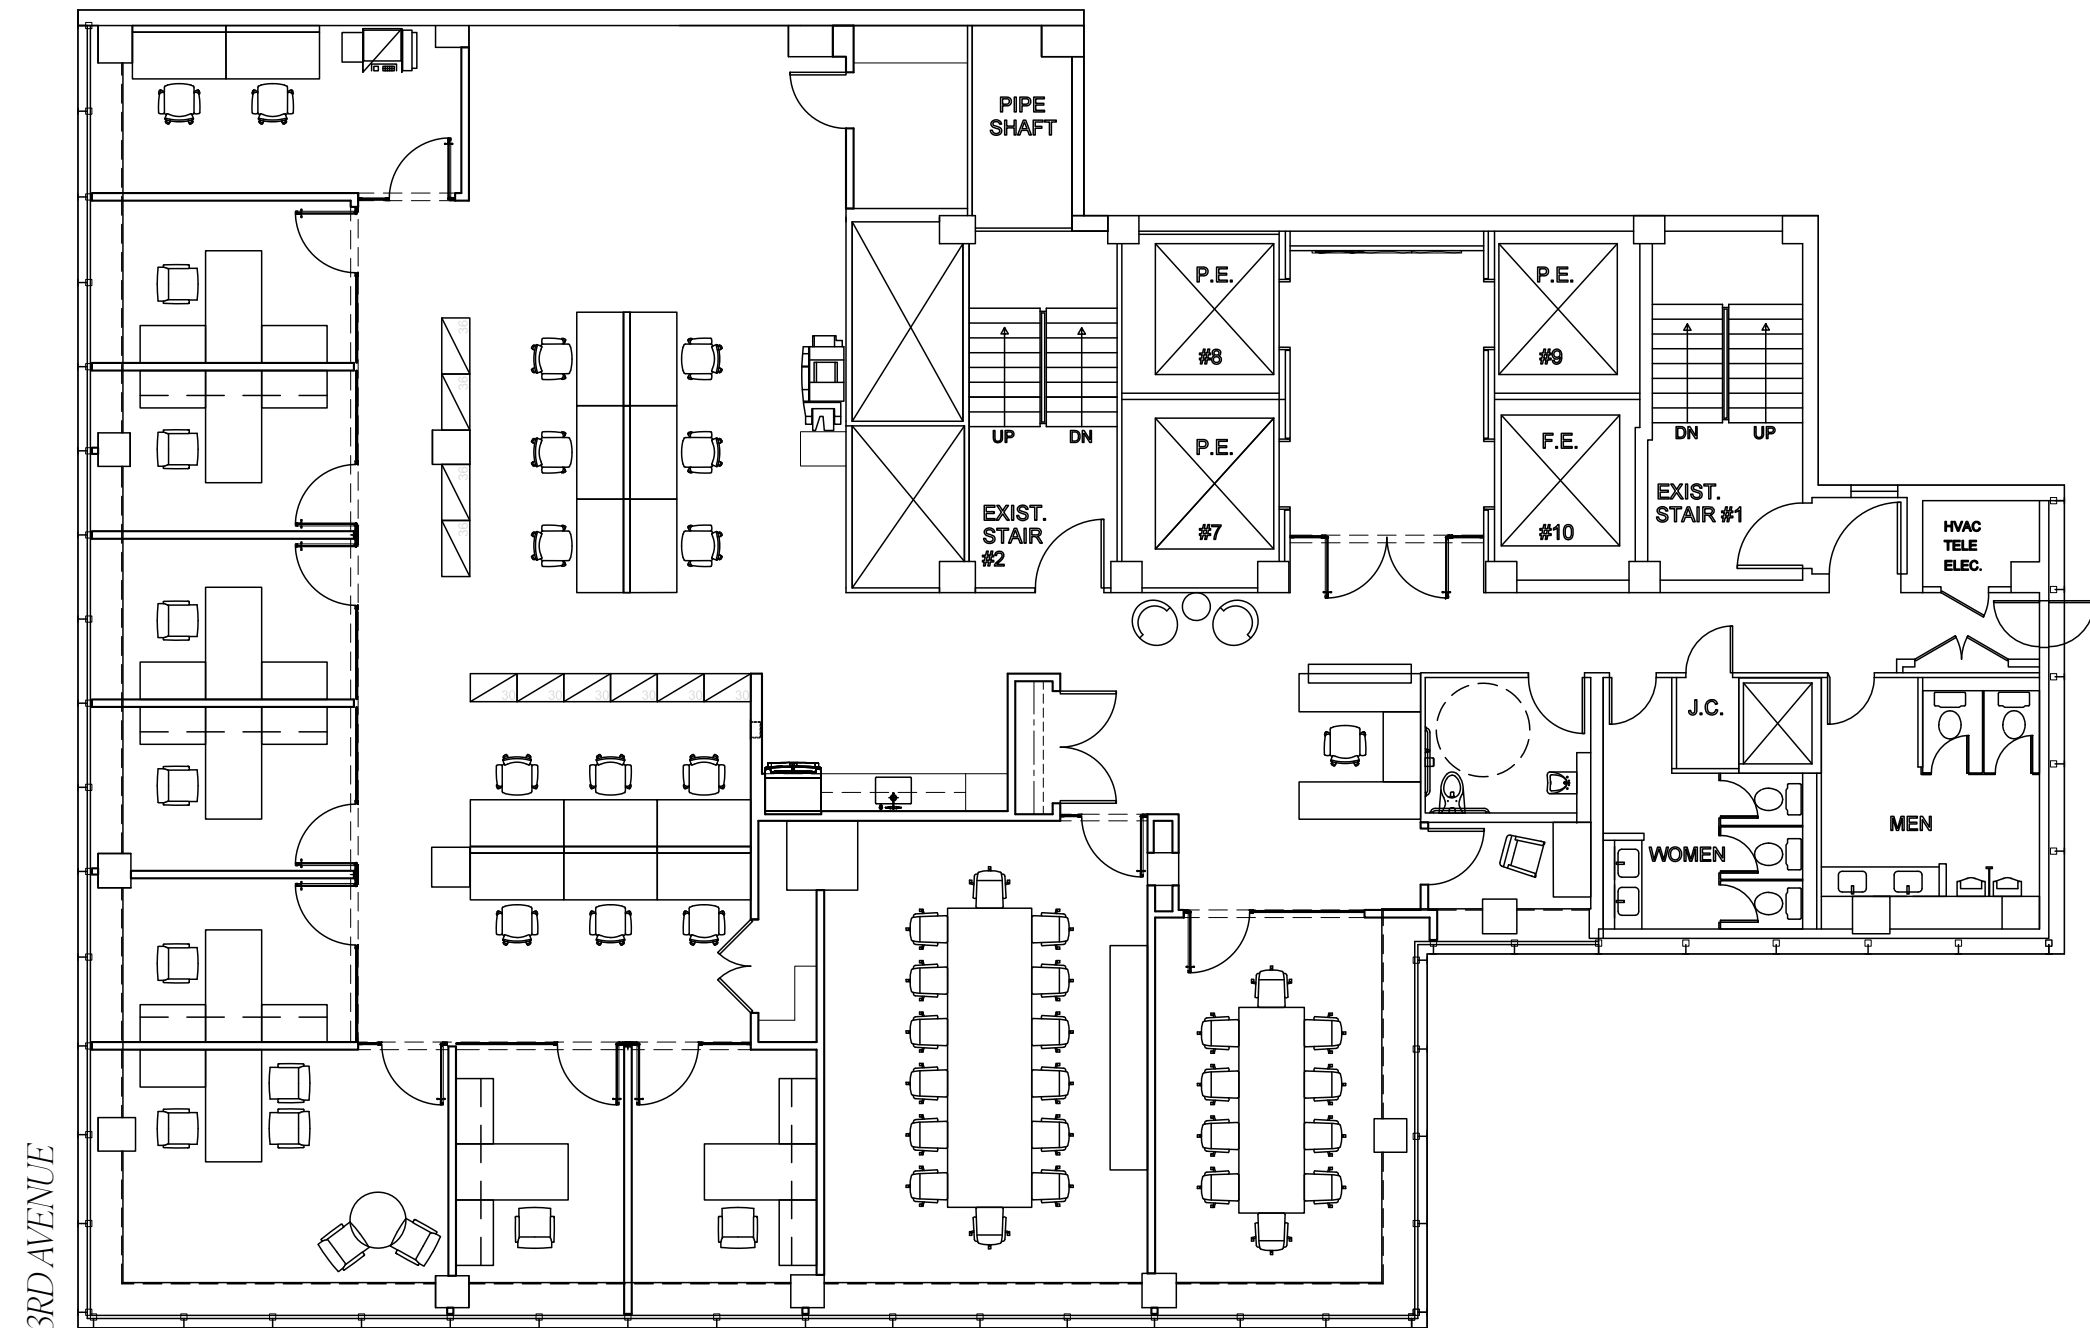

E 47TH STREET