



757 THIRD AVE

Floor - 26

*As-Built Plan*

*6,960 SF*

*Single Suite*

Workstations 32


Offices 2

Conference Rooms 3

Phone Rooms 2

Reception 1

Total 40

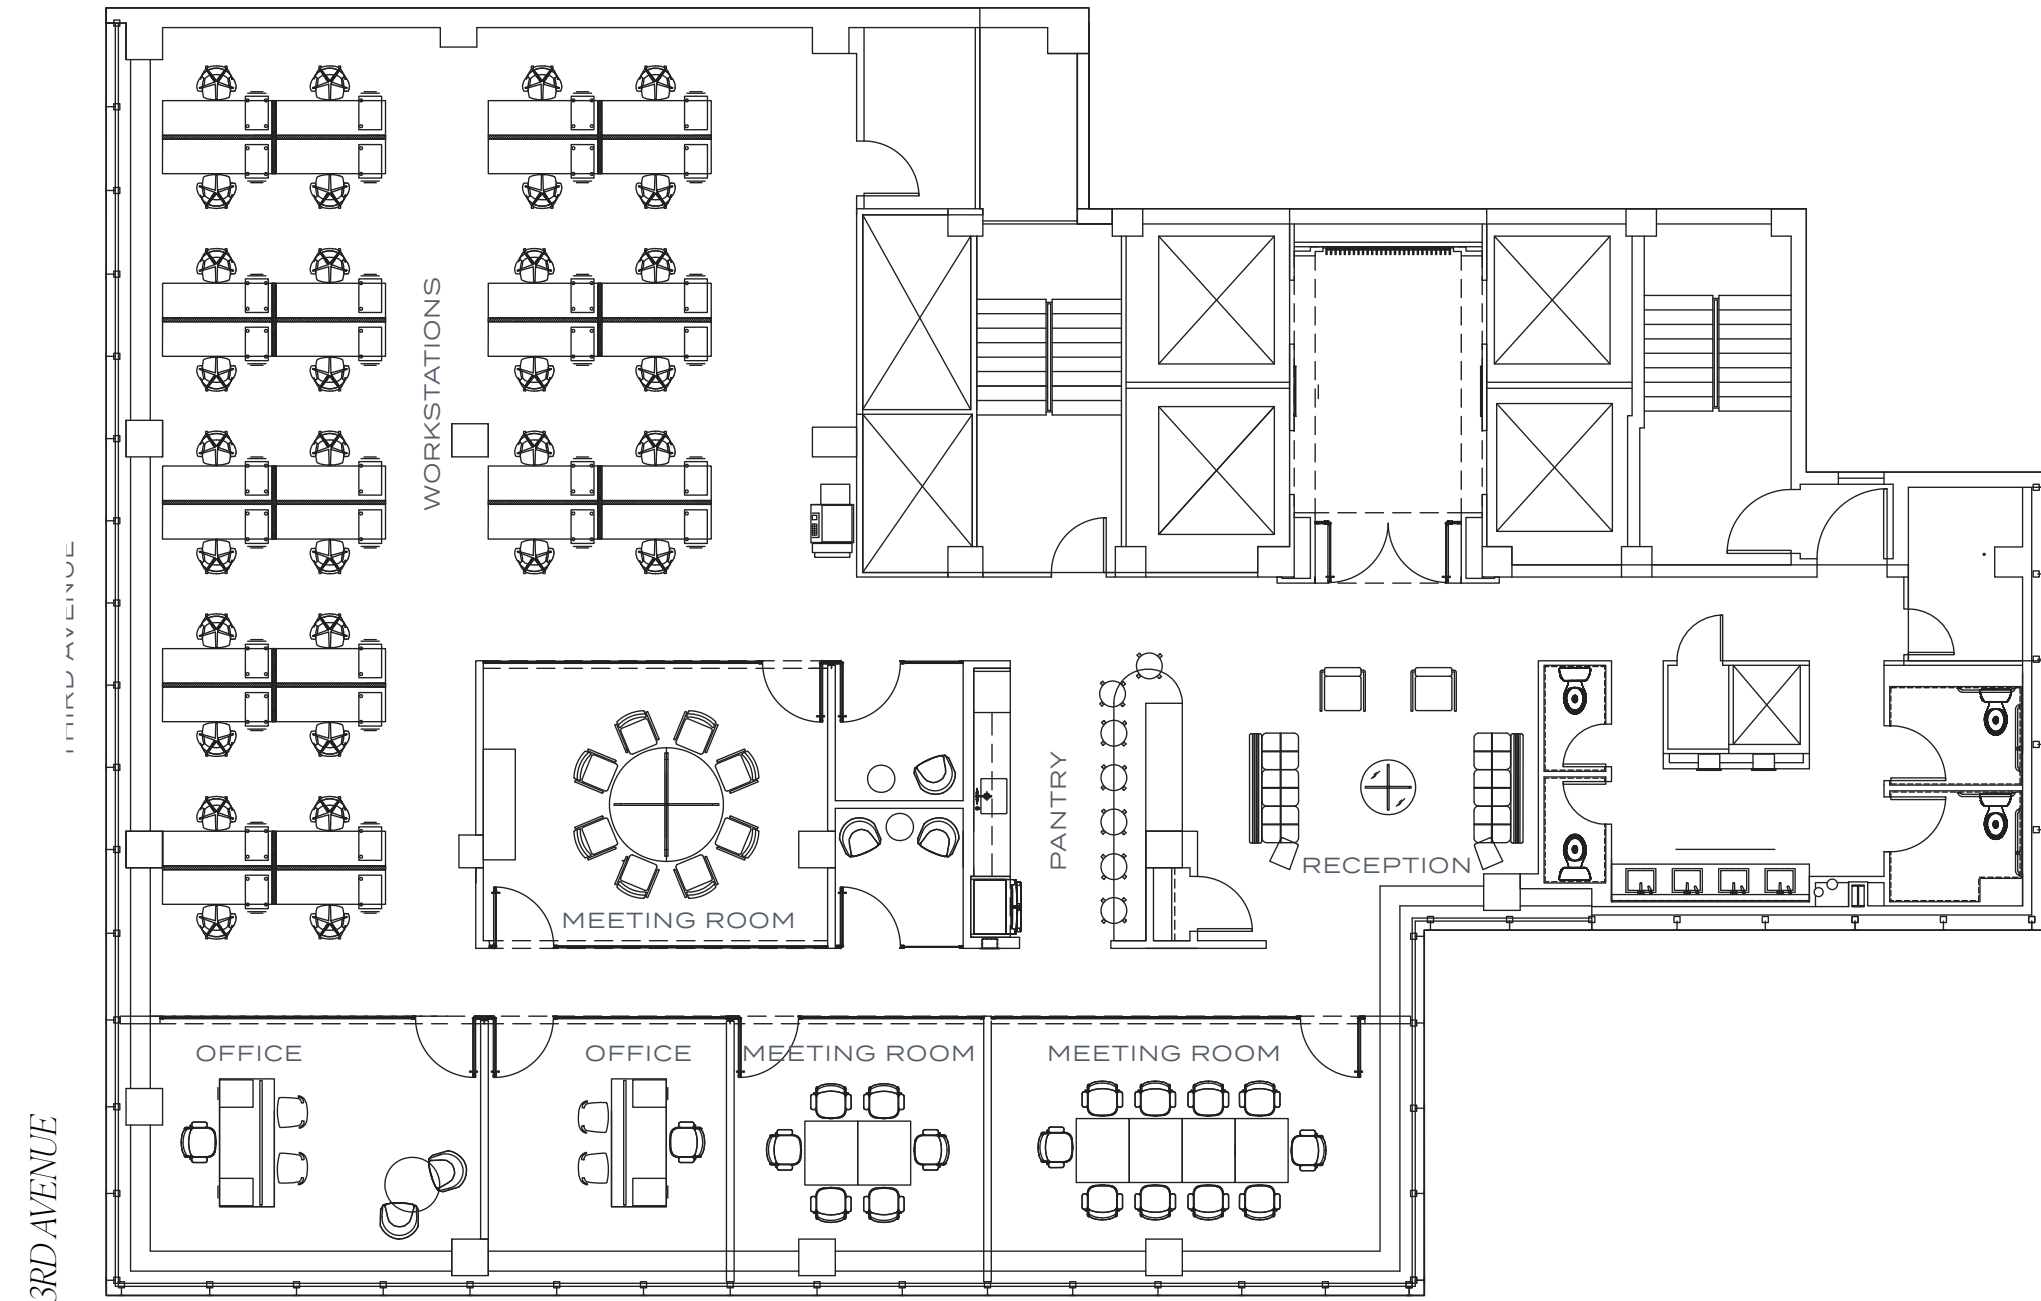

E 47TH STREET