




757 THIRD AVE

Floor - 08

As-Built Plan
Suite A
10,475 SF

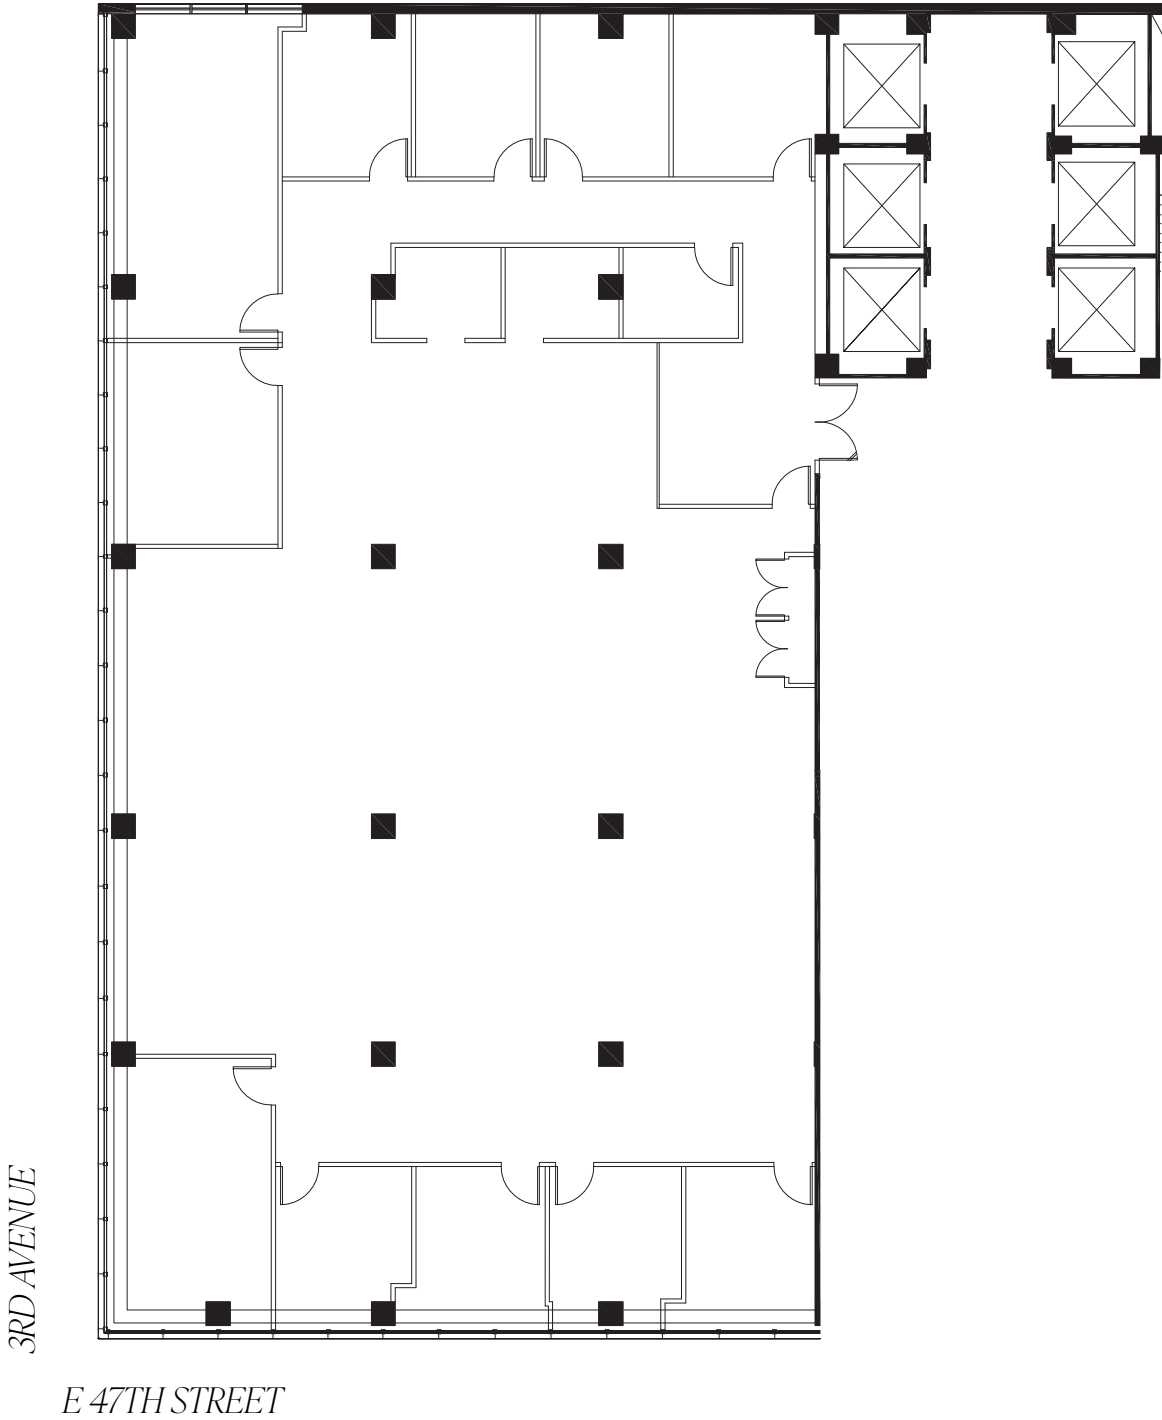




757 THIRD AVE

Floor - 08

As-Built Plan
Suite B
13,458 SF

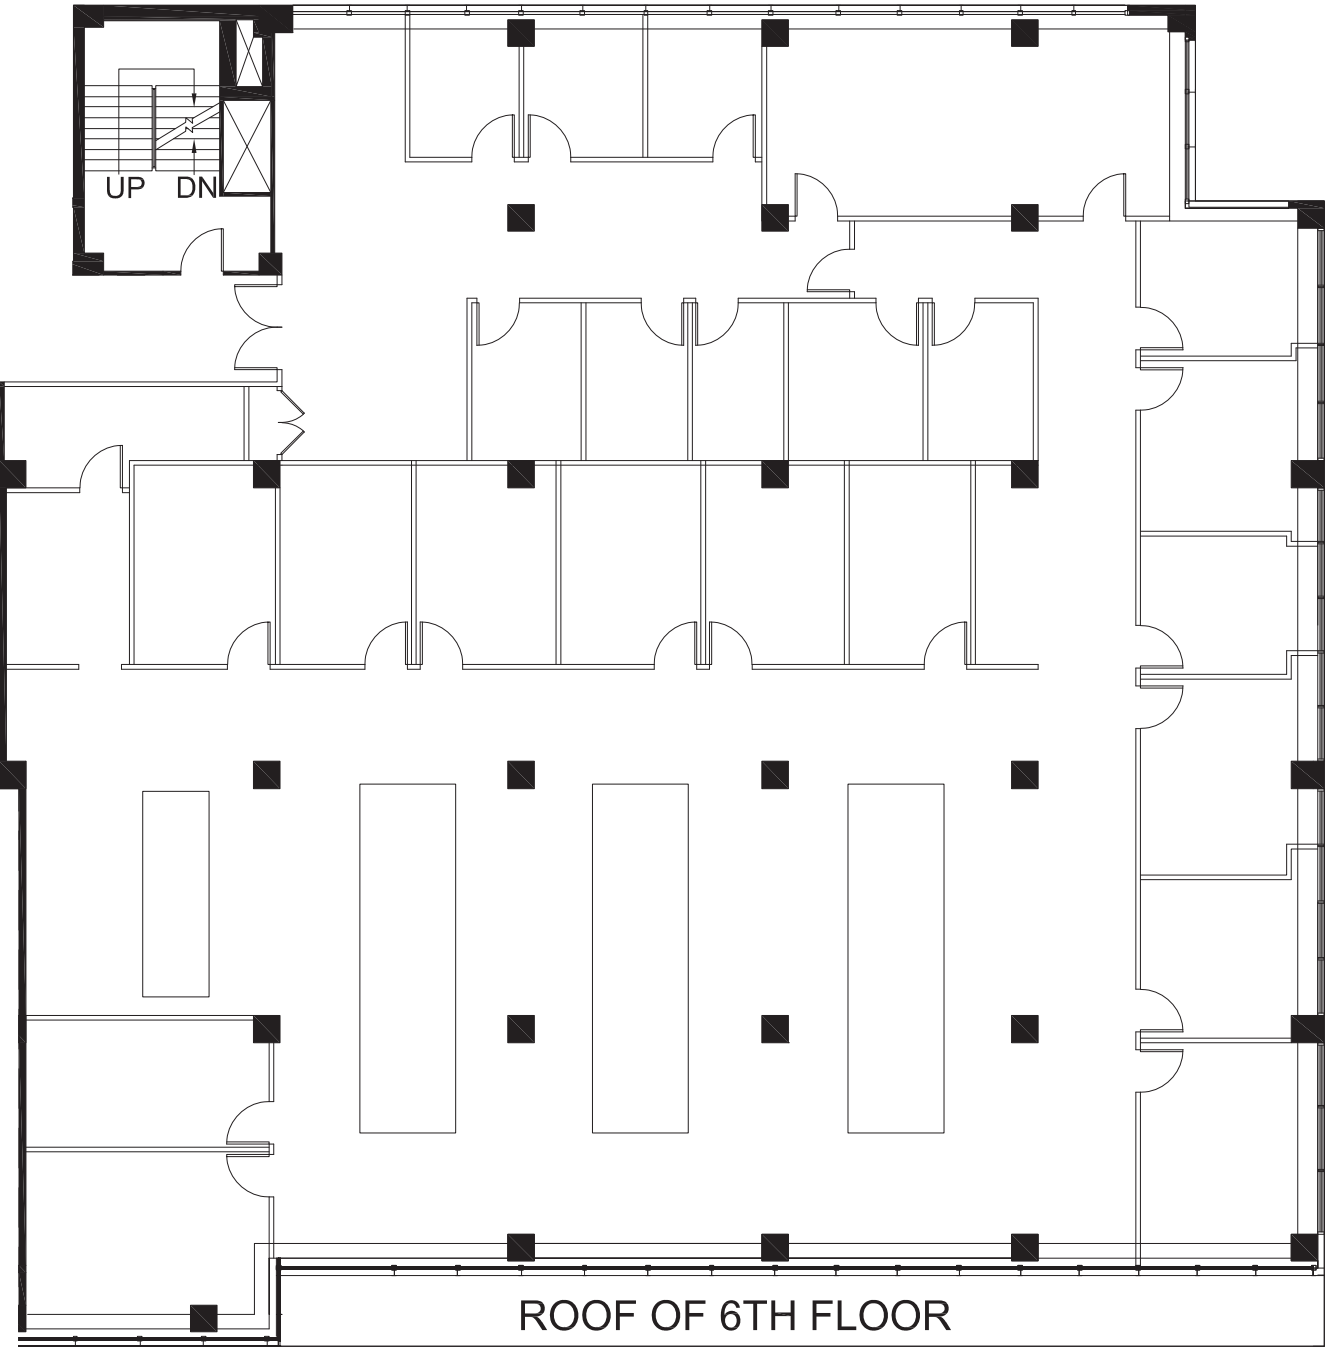

E 47TH STREET